
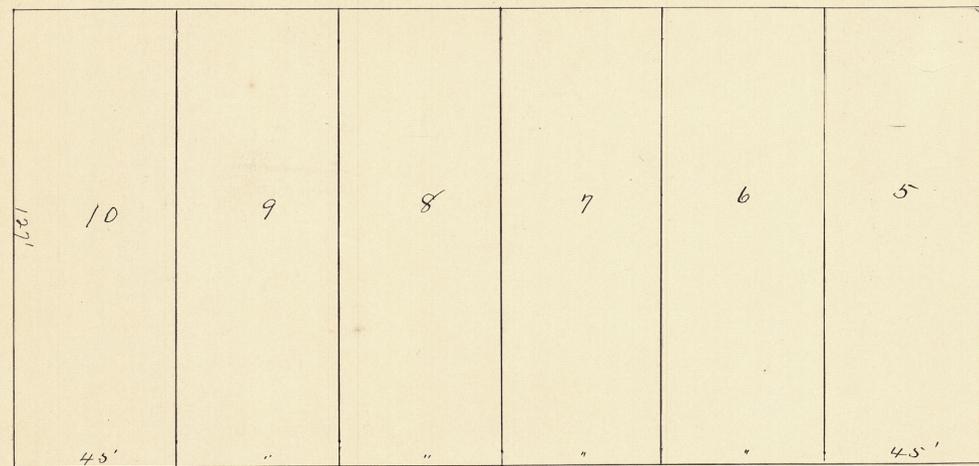


ALLEGHENY

ST.

Seventh St

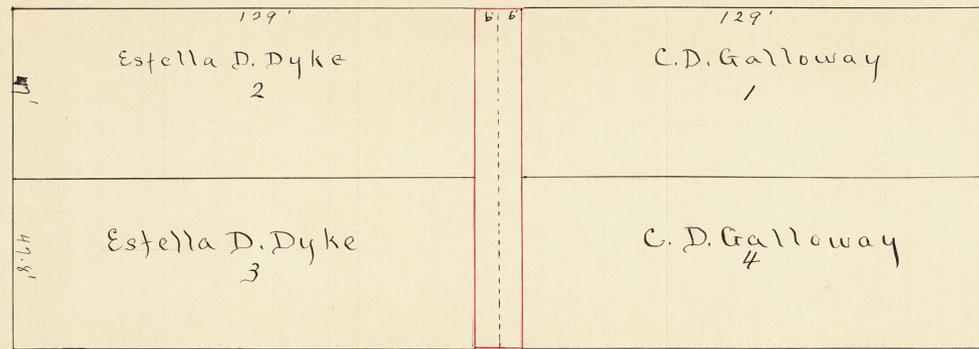

Park

State of Minnesota

County of Mower ss

Geo. L. Brown, being first duly sworn, deposes and says that he is a professional engineer or land surveyor of the State of Minnesota, duly registered in accordance with provisions of law as a registered land surveyor.

That the plat attached hereto is a true and correct plat of two alleys, one lying in the East side of Lots 2 & 3 and on the West side of Lots 1 & 4 in Block 6, and the other alley lying in the East side of Lots 2 & 3 and on the West side of Lots 1 & 4 in Block 7, Orchard Park Addition to the City of Austin.

The premises shown within the red lines which are indicated upon the plat are the premises affected by and vacated by certain proceedings completed by the Common Council of the City of Austin as finally set forth and shown by Resolution No. 1205 of said City.

Further affiant saith not.

Subscribed and sworn to before me this 19th day of May, 1933.

Arthur R. Johnson Notary Public, Mower County, Minn.

My commission expires April 5, 1940.



(Notarial Seal)

G. L. Brown Reg. P.E. & L.S.

Ave.

Sixth St

Sixth

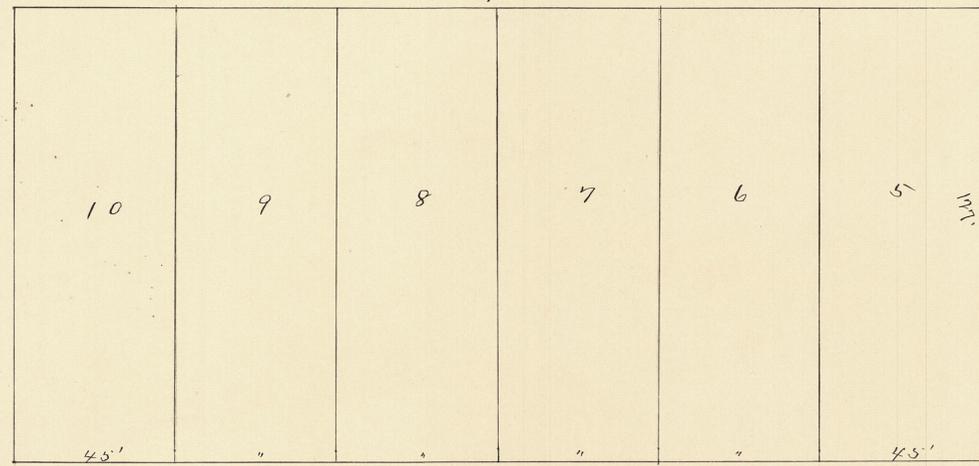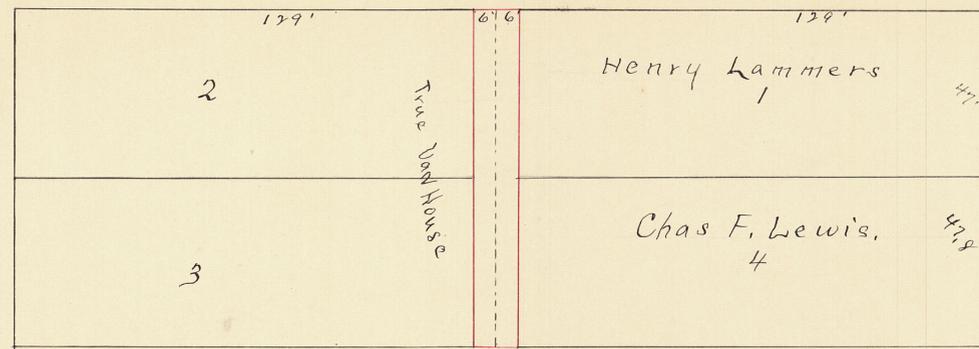

Fifth St

Fifth



Plat of Vacated Alleys in Blocks 6 & 7 Orchard Park Addition To The City of Austin, Minn. Scale 1"=30'

Note.

Area Enclosed in Red to be vacated.

These Alleys were vacated December 1, 1933.