Taxes paid and transfer entered this 14 day of Aug 1951
C. M. Hubbard
County Auditor

I hereby certify that taxes for the year 1950 on the lands described within are paid.
C. C. Derry
County Treasurer

BEL-AIR

FIRST ADDITION TO THE CITY OF AUSTIN

MOWER COUNTY — STATE OF MINNESOTA

202136

Office of Register of Deeds
Mower County Minnesota SS.
I hereby certify that the within instrument was filed for record on the 14 day of Aug A.D. 1951 at 3:45 o'clock P.M. and duly recorded in Book 7 of Plats on page 41
Register of Deeds
By ____ Deputy

SYMBOLS


PLATTED AREA = 59.16 ACRES
SCALE :- 1" = 100 FT.

I hereby certify that this survey, plan, or report was prepared by me or under my direct supervision and that I am a duly Registered Land Surveyor under the laws of the State of Minnesota.

C. E. Milnor
7-23-1951 Reg. No. 1476

CITY OF AUSTIN	RES. NO.	DATE
ANNEXATION		
PLAT		
APPROVALS		
MAYOR		
CITY ENGINEER		
CITY RECORDER		

CERTIFICATES	BOOK	PAGE
DEDICATION	X	532
SURVEYOR'S	X	532
Citys Recorders	X	532

AUSTIN HIGH SCHOOL ATHLETIC FIELD

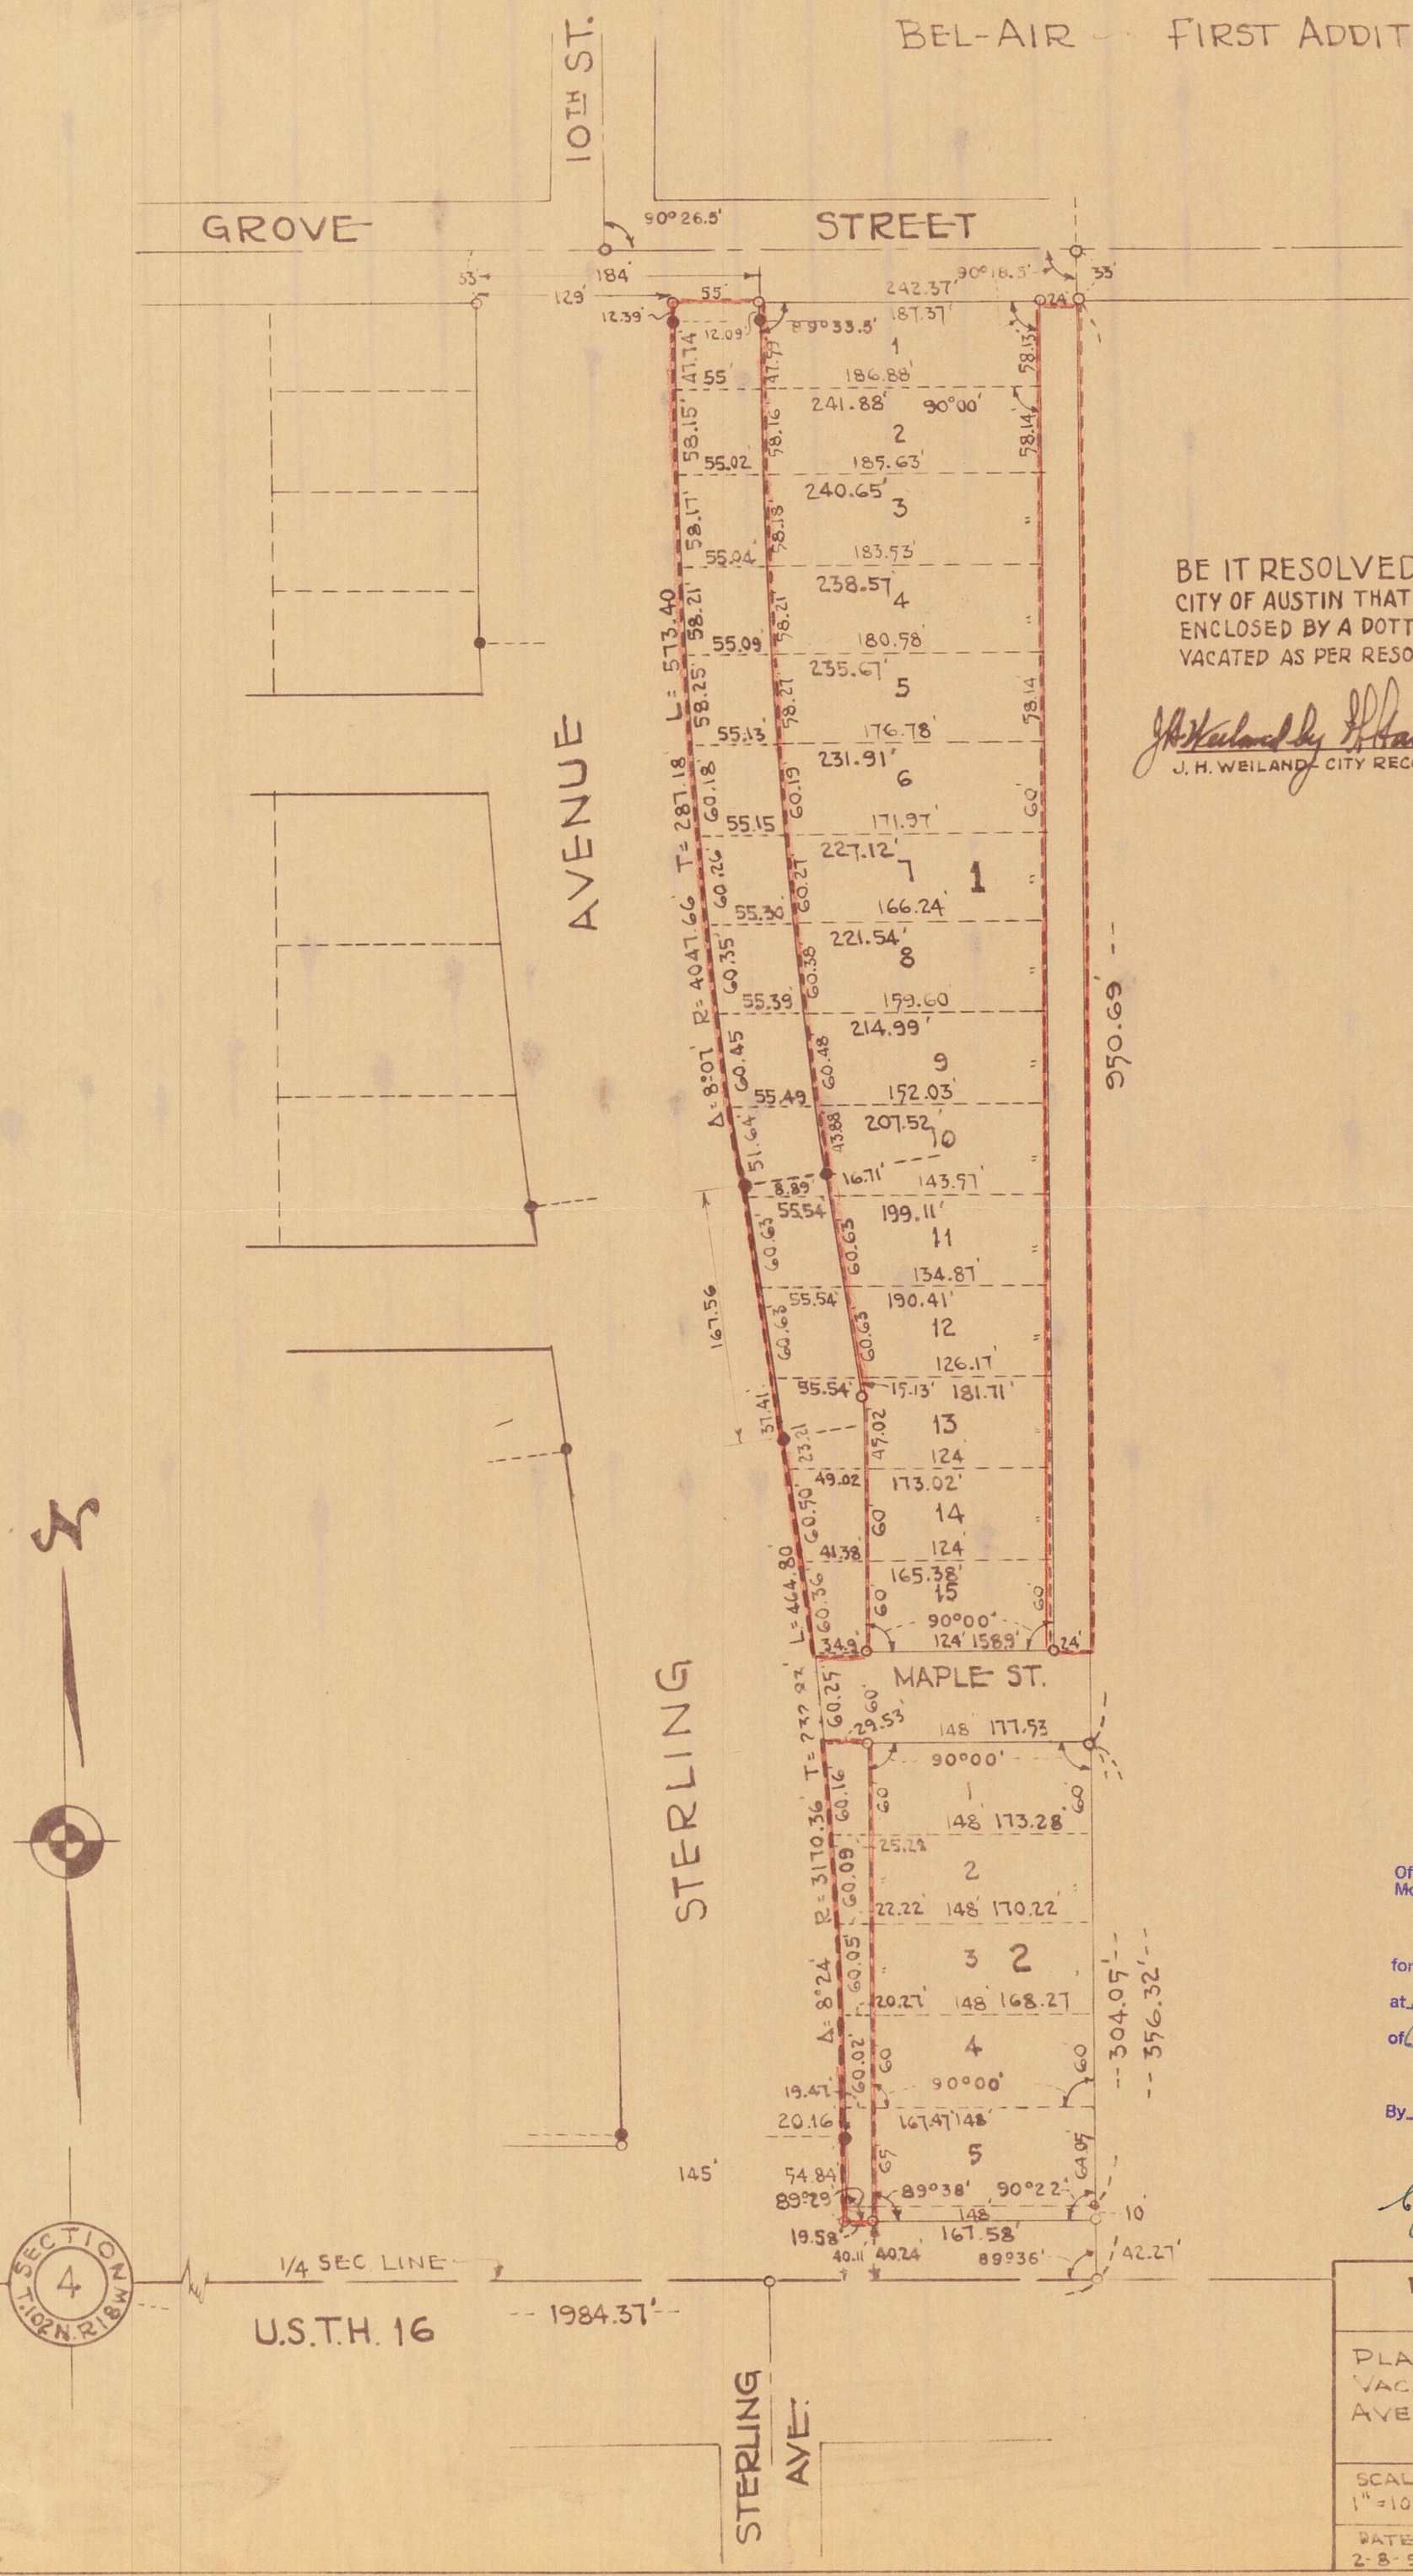

BE IT RESOLVED BY THE COMMON COUNCIL OF THE CITY OF AUSTIN THAT THE LAND SHOWN ON THIS PLAT, AND ENCLOSED BY A DOTTED RED LINE, IS HEREBY DECLARED VACATED AS PER RESOLUTION Nº 3078, DATED OCT. 4, 1957.

J. H. Weiland by P. Hanson — J. H. WEILAND - CITY RECORDER.

R. W. Nelson — R.W. NELSON - CITY ENGINEER.

Office of Register of Deeds, Mower County, Minnesota } SS. 245321

I hereby certify that the within instrument was filed for record on the 20 day of April A.D., 1959 at 10 o'clock A.M. and duly recorded in Book 9 of Plats on page 28

Register of Deeds

By _____, Deputy

Certificate see Books 200 mtgs Page 145

ENGINEERING DEPARTMENT
CITY OF AUSTIN MINNESOTA

PLAT SHOWING THE PROPOSED VACATION OF A PORTION OF STERLING AVE. IN BEL-AIR FIRST ADDITION TO AUSTIN, MINNESOTA.

SCALE 1" = 100'

DATE 2-8-57

R. W. NELSON CITY ENGINEER