

State of Minnesota ss.
County of Mower

Geo. L. Brown, being first duly sworn, deposes and says that he is a professional engineer or land surveyor of the State of Minnesota, duly registered in accordance with the provisions of law as a registered land surveyor.

That the plat attached hereto is a true and correct plat of that portion of Brownsdale Avenue in the City of Austin lying west of the west line of Oak Street in said City and the premises shown within the red lines which are indicated upon the plat are the premises affected by and vacated by certain proceedings completed by the Common Council of the City of Austin as finally set forth and shown by Resolution No. 1234 of said City.


Further affiant saith not.
Subscribed and sworn to before me this 6th day of February 1934.
Notary Public, Mower County, Minn.
My commission expires April 5, 1940.
(Notarial Seal)

Plat Showing Vacation of Brownsdale Avenue, Lying West of the West Line of Oak Street Austin, Minn.

Scale 1"=50'



Note
Area in Red to be vacated.

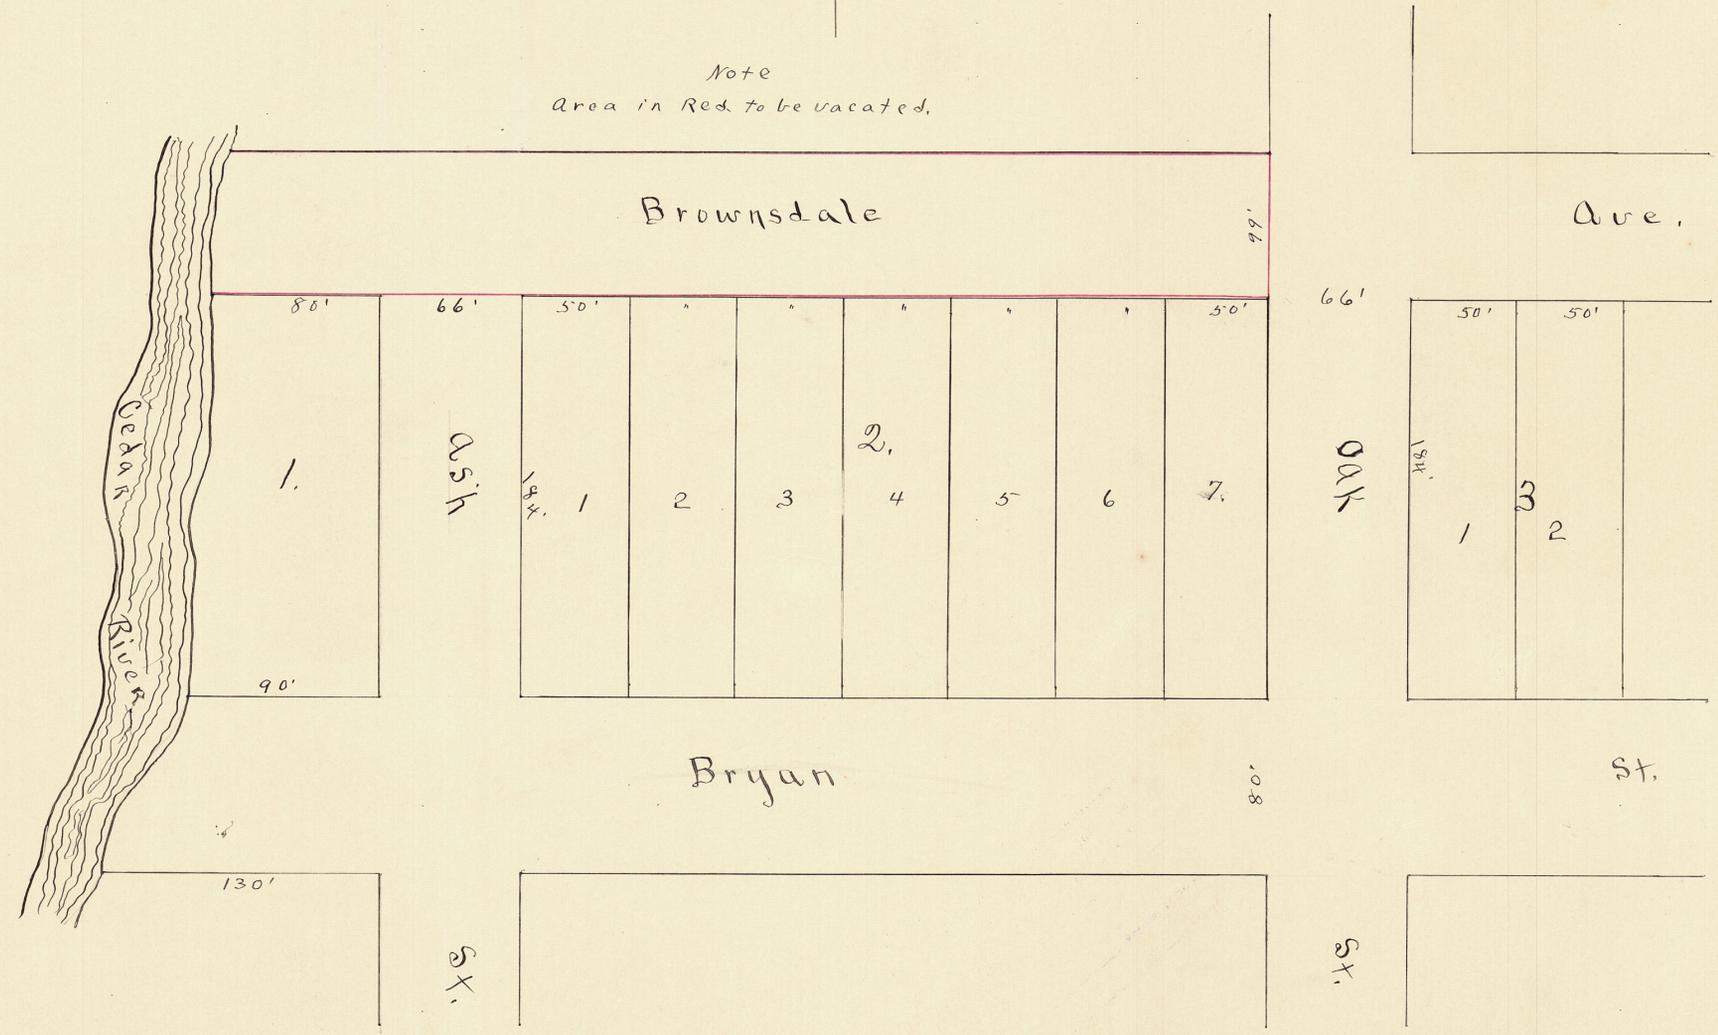

J. L. Brown
Reg. P.E. & L. S.